


DO KONTROLI
POWYKONAWCZ

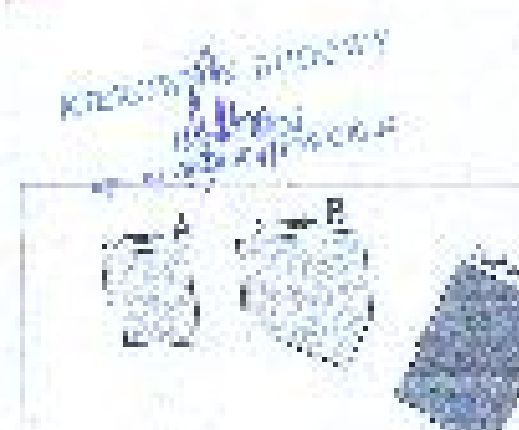

portal | pracownia projektowa

HEP: ann E 114, 8 (1992) BIPZ: <http://www.bipz.uni-leipzig.de/ann/2151/>

9. 计算题 (共 20 分)

TEL: 01-276-2222
FAX: 01-276-2222
E-MAIL: info@nissai.co.jp
WWW: www.nissai.co.jp

Copyright © 2004 John Wiley & Sons, Ltd.

Customer Satisfaction, Technology, and Service Quality

www.ck12.org

doi:10.1371/journal.pone.0142811.g001

my 2001 Dissertation, 1999

2018-19 120 D7

PA
20

Copyright © 2005 John Wiley & Sons, Inc. All rights reserved. No part of this publication may be reproduced, stored in a retrieval system, or transmitted, in any form or by any means, electronic, mechanical, photocopying, recording, scanning, or otherwise, except as may be permitted in writing by John Wiley & Sons, Inc.
