


<p><b>Wzrostki:</b> 2000, 2001, 2002, 267</p>
---

Do dnia 6.11.2009 roku wlotnik uzupełniono o projekt ZUDP 412/09 i 1091/2009.

06.04.2009 r.

1000

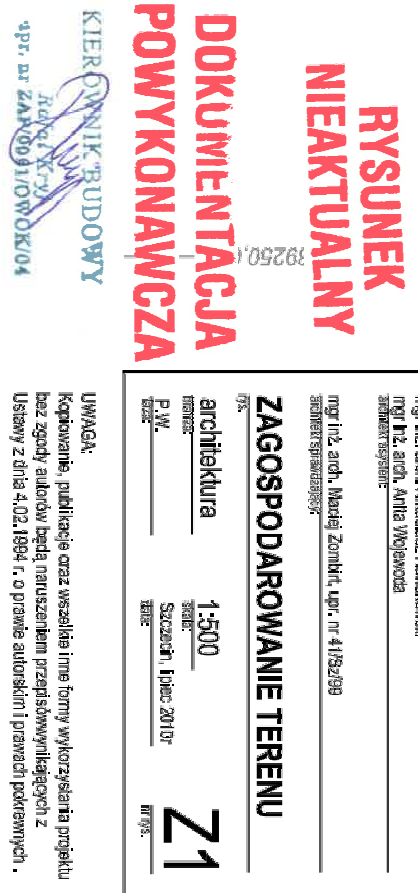

- [illegible]