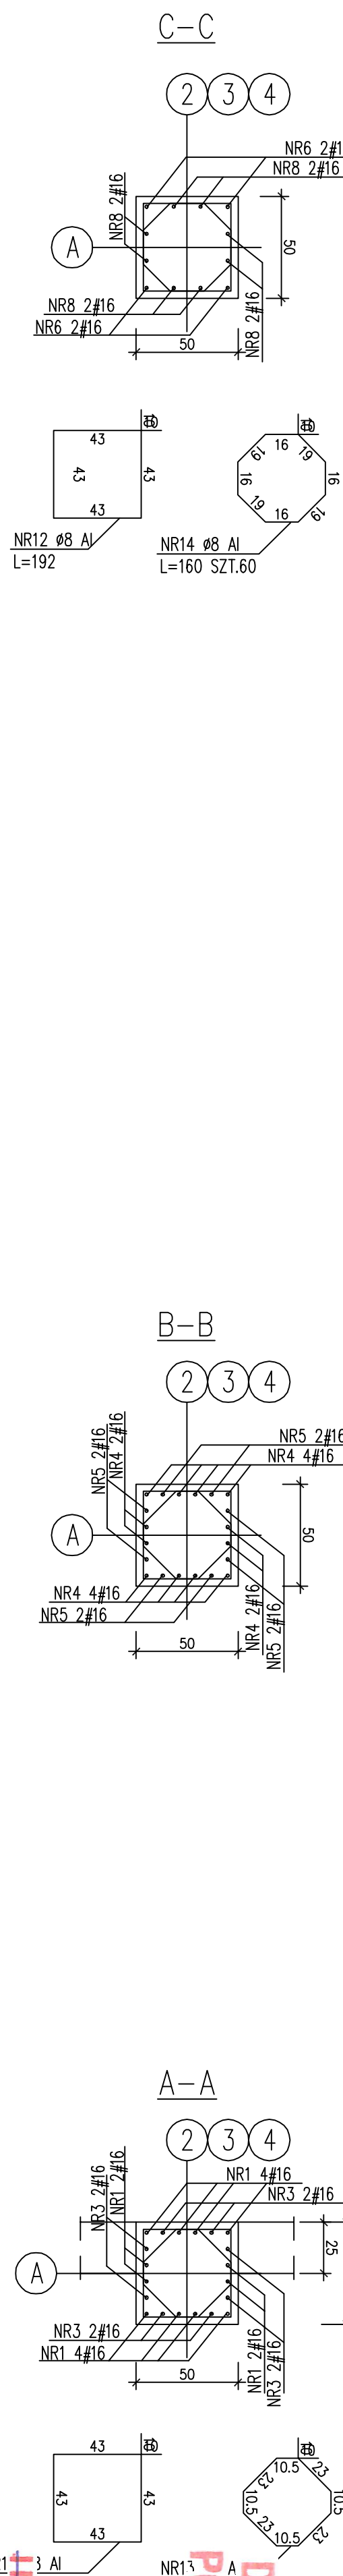






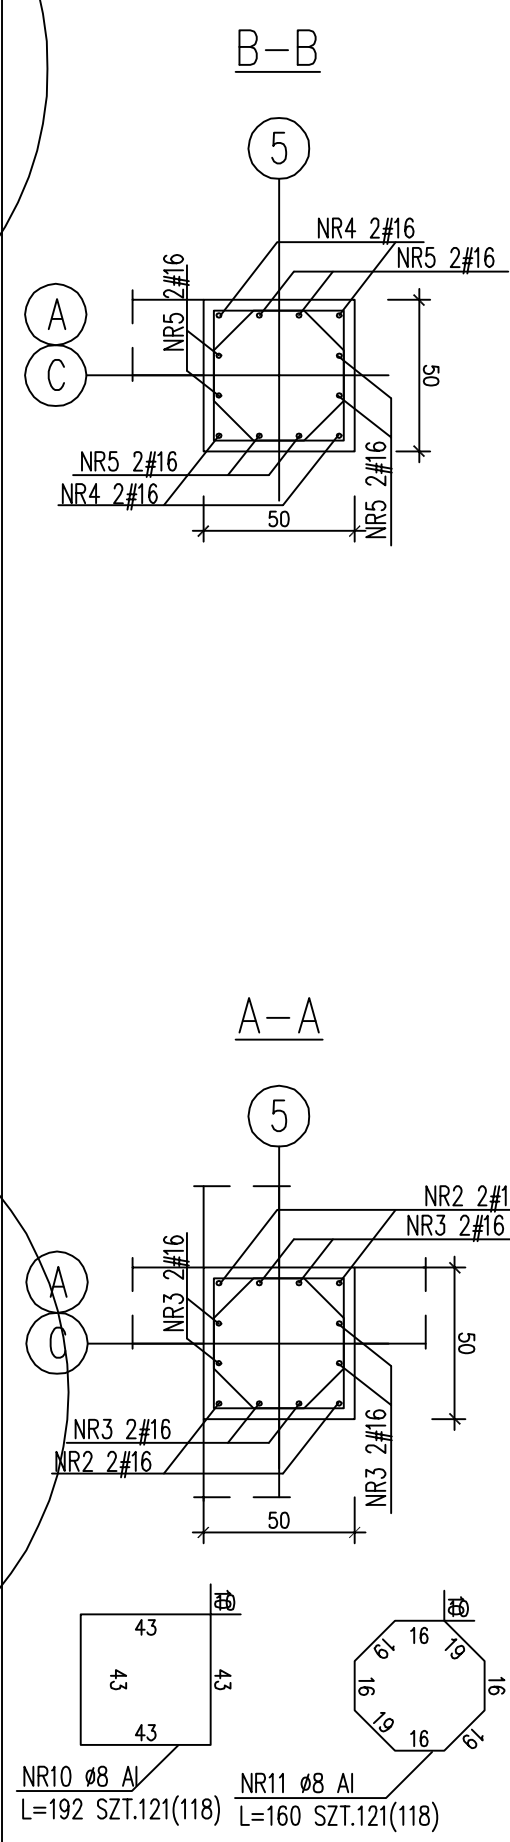
**DOKUMENTACJA
POMYKONAWCZA**

**WYKONANO ZGODNIE
Z PROJEKTEM**

1. NAWIESZONYMI ZNAKAMI

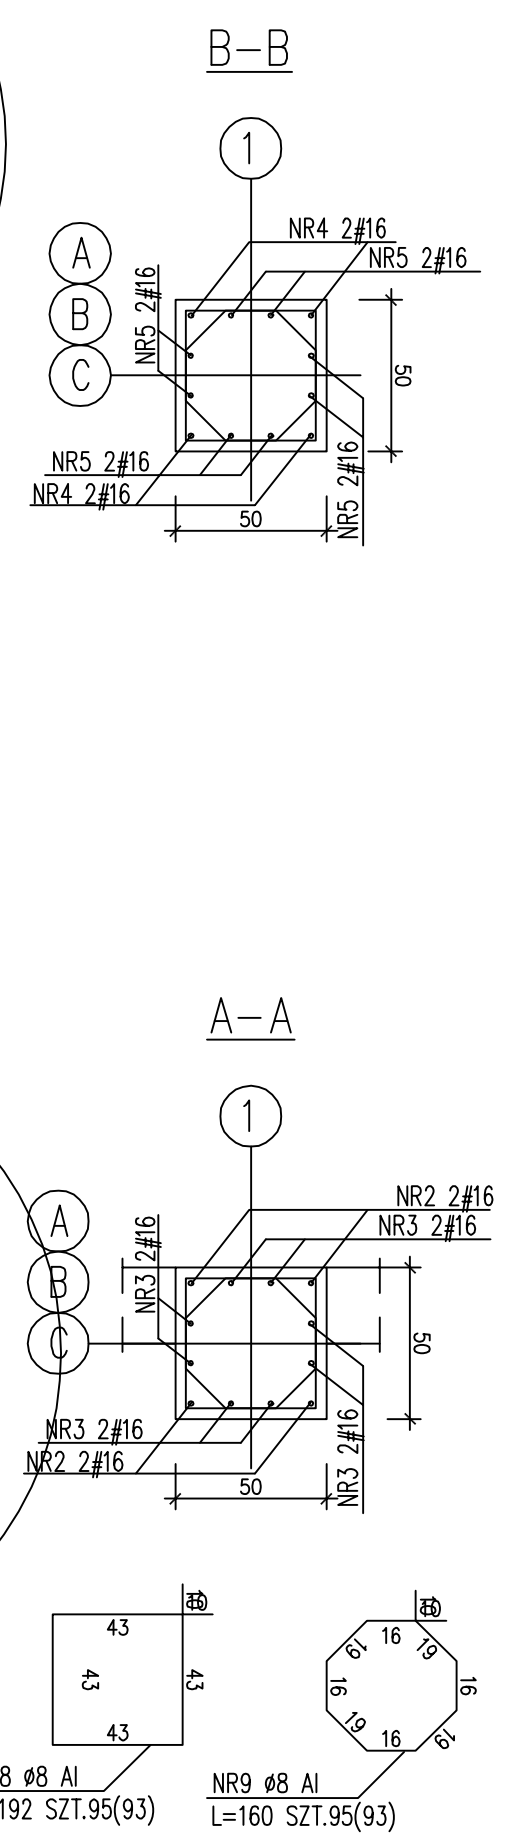
**3. ALI
SZT. 121**

**NR 1
L=1.**

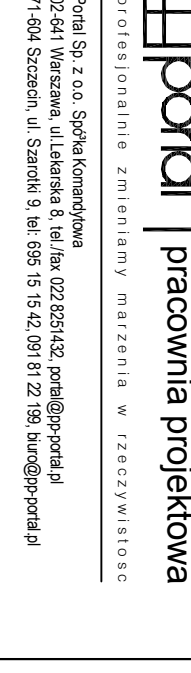
[illegible]






[illegible]

